

IN THE DRAWINGS

Fig. 3 has been amended as illustrated in the attached red-lined and replacement copy.

Red-lined version

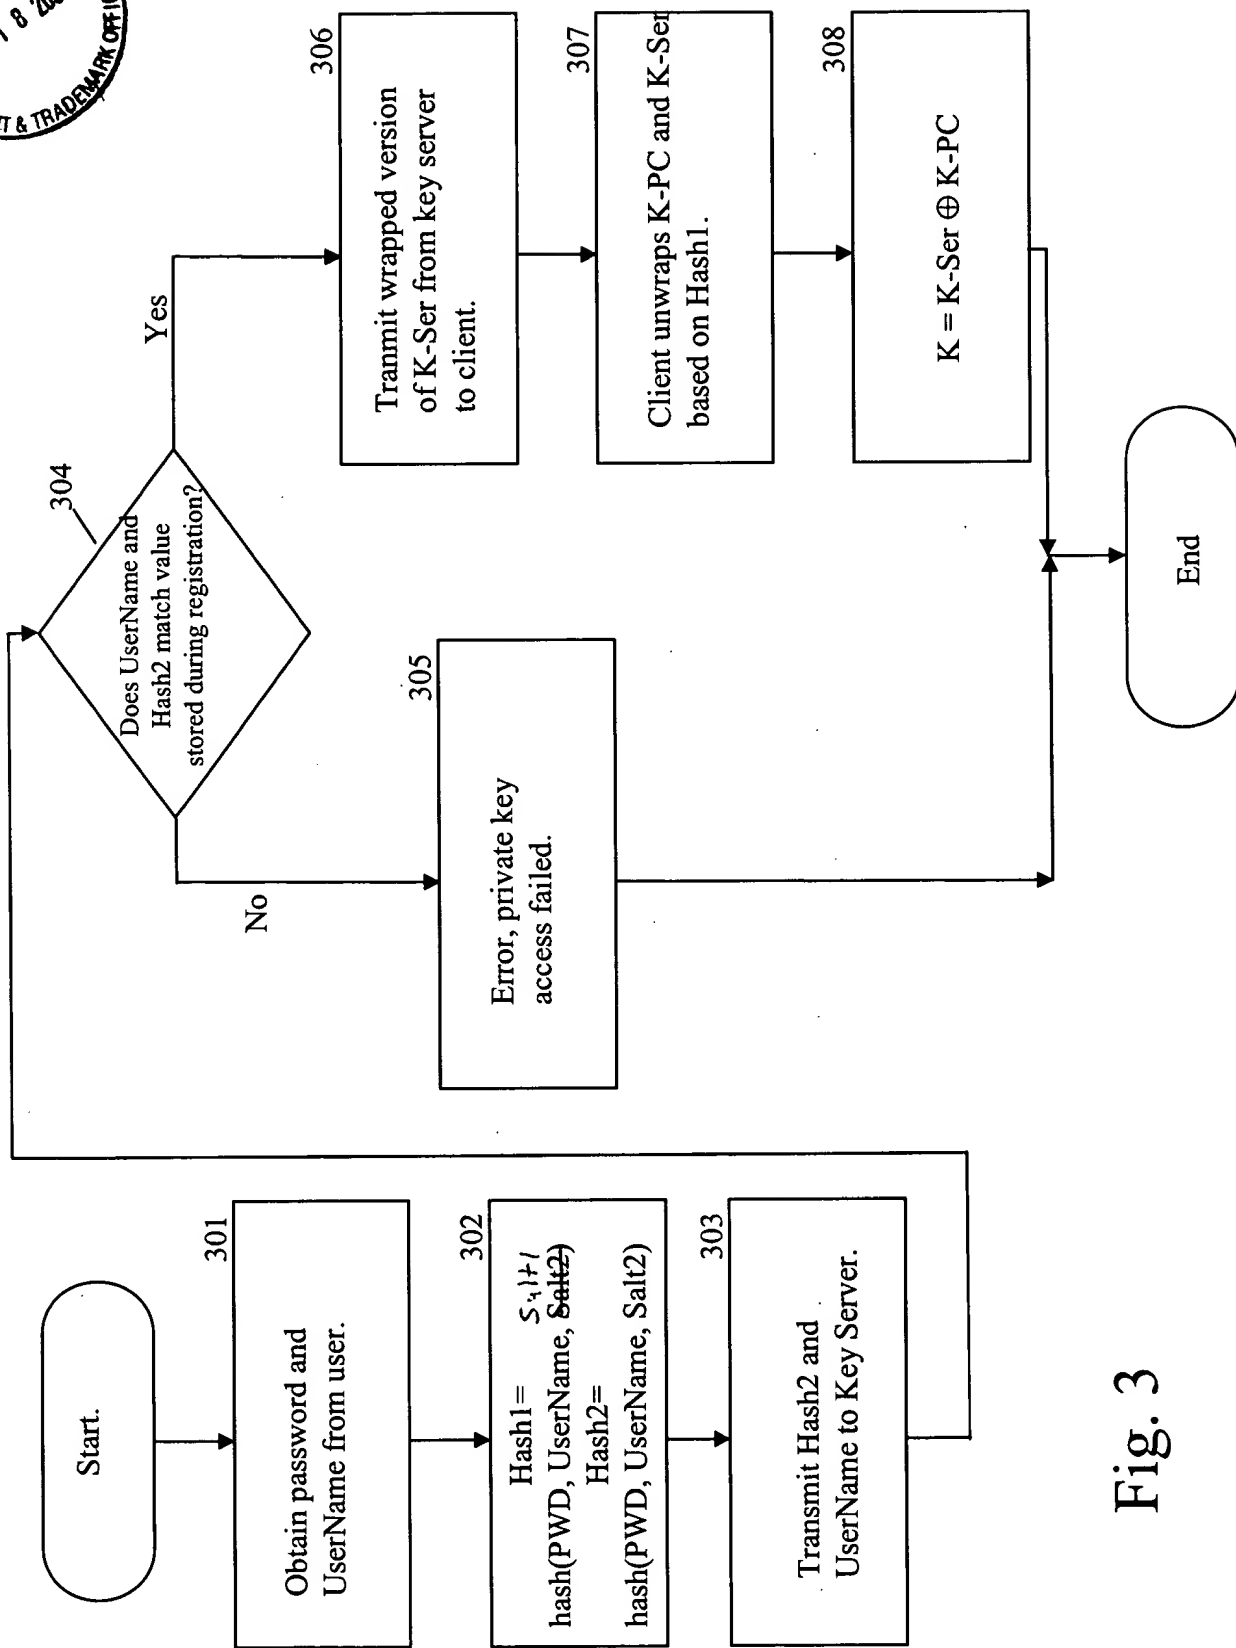


Fig. 3

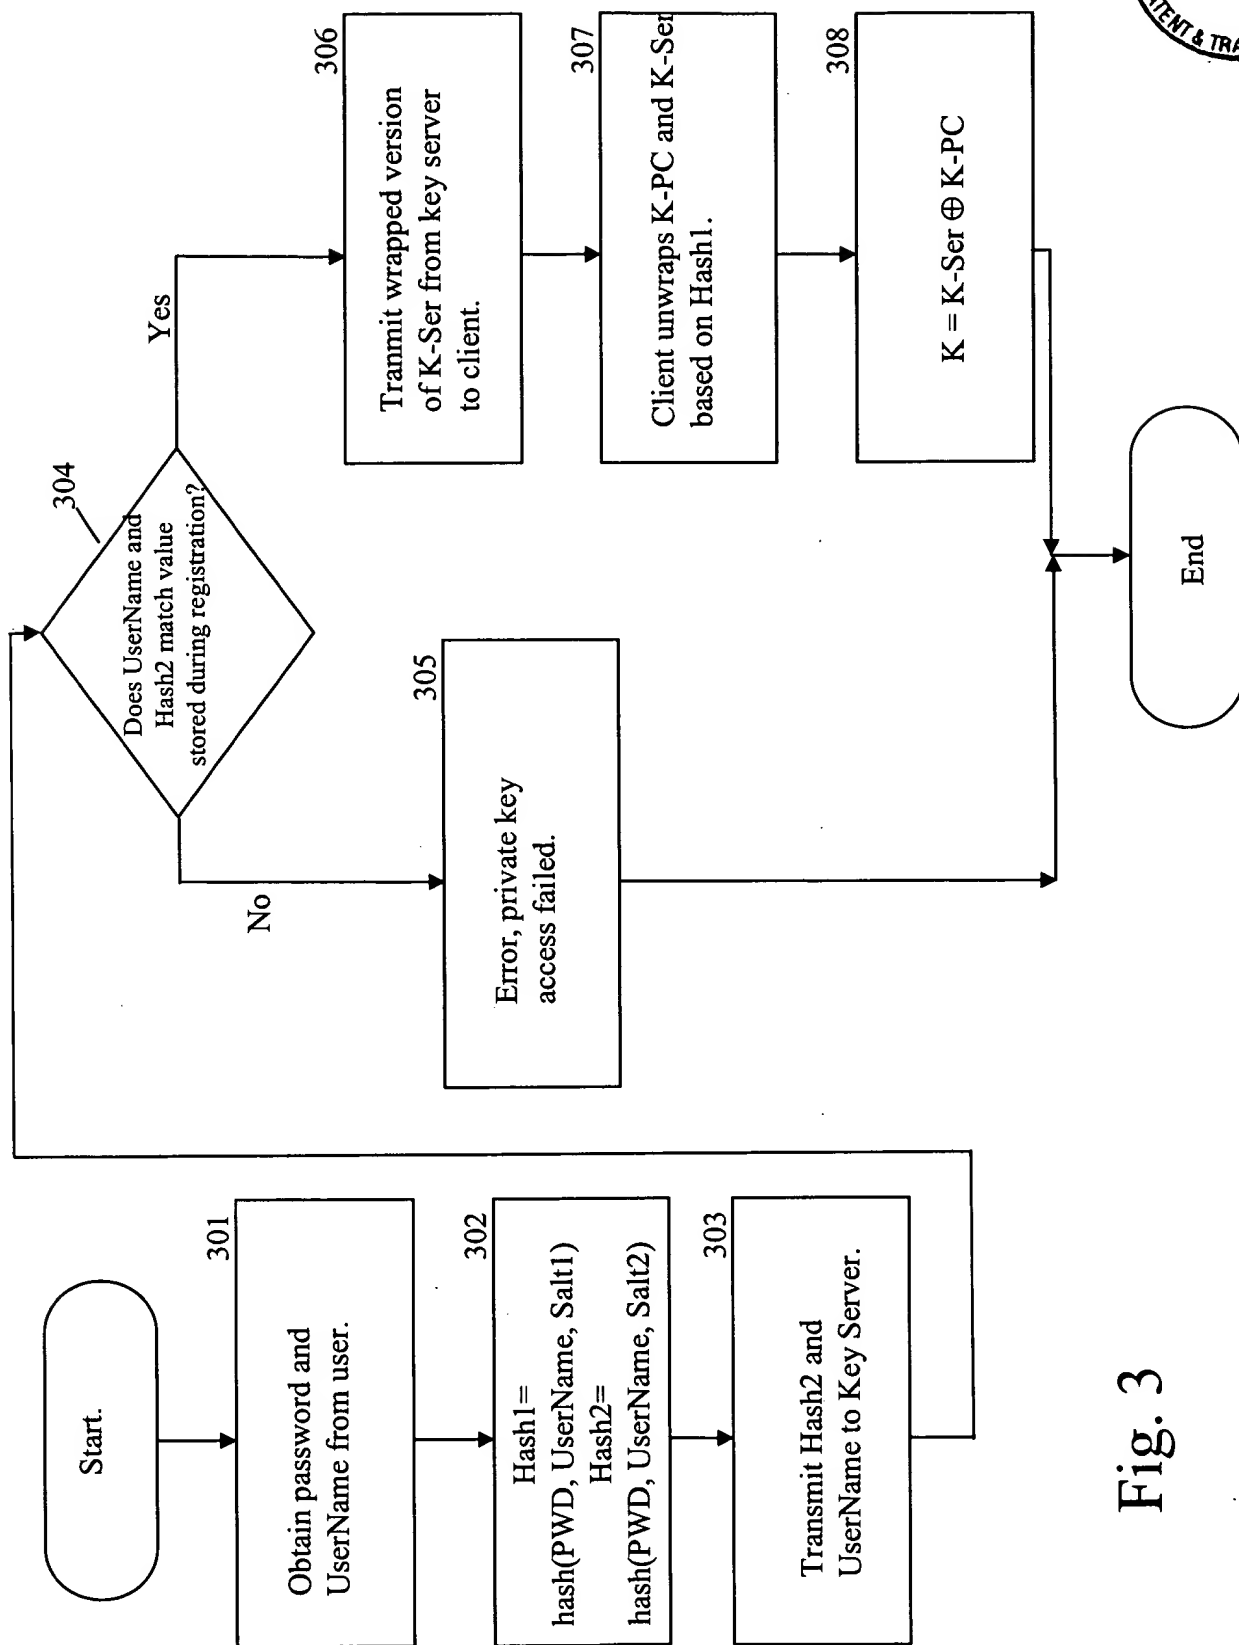


Fig. 3